


① 0090008

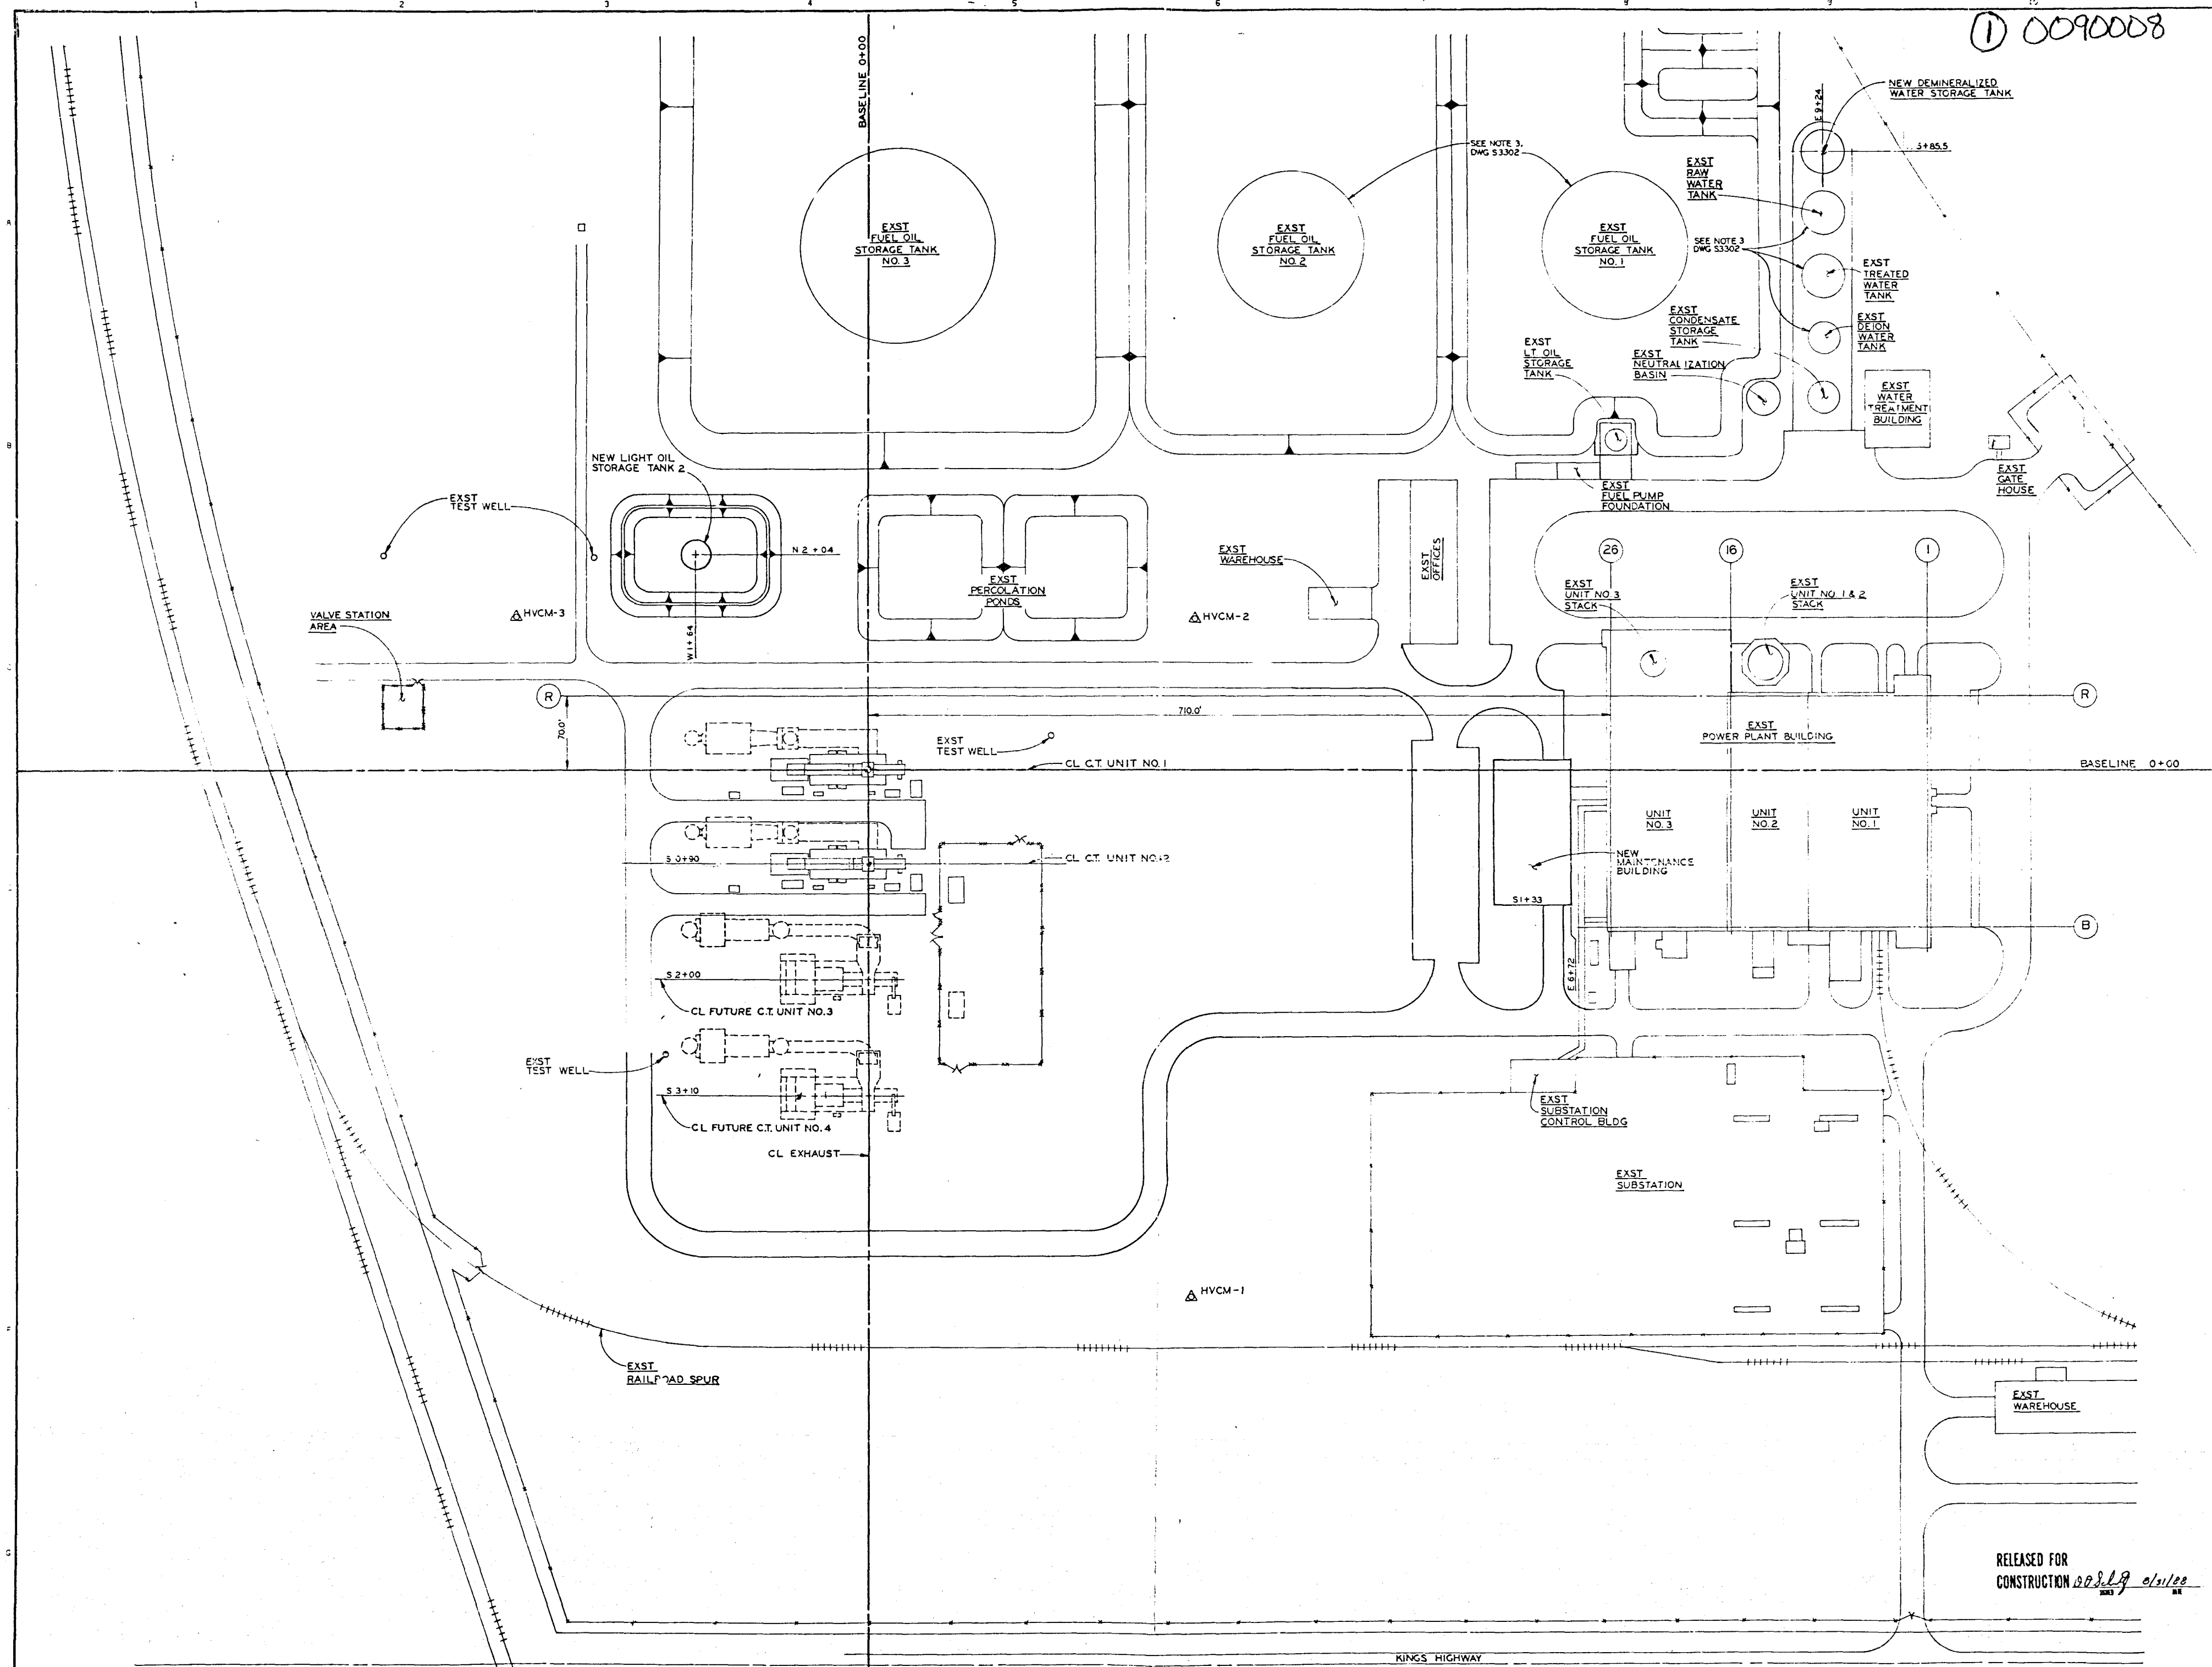

RELEASED FOR CONSTRUCTION *02/29/88* *el/lee*

3	10-20-88	REVISED FUTURE UNITS 3&4 AREA	<i>[Signature]</i>	50'	100'	I HEREBY CERTIFY THAT THIS DOCUMENT WAS PREPARED BY ME OR UNDER MY DIRECT SUPERVISION AND THAT I AM A duly REGISTERED PROFESSIONAL ENGINEER UNDER THE LAWS OF THE STATE OF FLORIDA. SIGNED: <i>[Signature]</i> DATE: 9-6-88 REG. NO. 32285	BLACK & VEATCH ENGINEERS-ARCHITECTS ENGINEER: RLW CHECKED: KFS DATE: 9-6-88	ORLANDO UTILITIES COMMISSION INDIAN RIVER PLANT SITE ARRANGEMENT	PROJECT: 14137-CSTU-S1001 SHEET NUMBER: 5
2	9-6-88	GENERAL REVISIONS	<i>[Signature]</i>	50'	100'				
1	8-12-88	GENERAL REVISIONS	<i>[Signature]</i>	50'	100'				
0	7-12-88	INITIAL ISSUE	<i>[Signature]</i>	50'	100'				
5	11-15-89	CONFORMED TO CONSTRUCTION RECORDS	<i>[Signature]</i>	SCALE: 1" = 50'					
4	11-18-88	GENERAL REVISIONS	<i>[Signature]</i>	BY: E. H. APPFELM					